

August 28, 2025

This addendum forms a part of the contract documents and modifies the original bid documents for the project.

In case of conflicts between this addendum and previously issued documents, this addendum shall take precedence.

This Addendum consists of the following:

Addendum Language (Pages 1 through 5)

Contract Document Attachments:

Index

Technical Specification Attachments:

Section 232416 – Internal Combustion Engine Exhaust Piping

Drawing Attachments:

C305, C319, C320, C501

CONTRACT SPECIFICATIONS

AD1.01 INDEX TO SPECIFICATIONS

REPLACE Entirely with attached Index

TECHNICAL SPECIFICATIONS

AD1.02 232416 – Internal Combustion Engine Exhaust Piping

REPLACE Entirely with attached Specification

August 28, 2025

AD1.03 331100 – Water Distribution Piping

ADD 2.14 TRACER WIRE

- A. #12 stranded copper Type UL HMWPE (High Molecular Weight Polyethylene).
Daylight ends of the trace wire at each hydrant.

REPLACE 4.02 BASIS OF PAYMENT

- C. Payment for Contractor-Furnished Water Main will not be paid until the pipe is
furnished, transported, insulated, and installed.

WITH 4.02 BASIS OF PAYMENT

- C. Tracer wire shall be subsidiary to HDPE water main.

DRAWINGS**AD1.04 C305 – PLAN AND PROFILE – AIRPORT ROAD (2 OF 14)**

REPLACE Sheet entirely with Attached.

- Updated casing size at STA 50+35 – 54+06 to 12" HDPE

AD1.05 C319 – PLAN AND PROFILE – ENDICOTT ROAD TO AIRPORT ACCESS ROAD

REPLACE Sheet entirely with Attached.

- Updated casing size at ~STA 224+00 to 12" HDPE

AD1.06 C320 – PLAN AND PROFILE – AIRPORT ACCESS ROAD

REPLACE Sheet entirely with Attached.

- Updated casing size at STA 230+32 – 231+51 to 12" HDPE
- Updated casing size at STA 235+21 – 236+87 to 12" HDPE

August 28, 2025

AD1.07 C501 – WATER PIPING DETAIL

REPLACE Sheet entirely with Attached.

- Updated Detail A to show Detectable Warning Tape for all trenched piping and clarified the tracer wire is only for HDPE piping.

QUESTIONS AND RESPONSES:

1. **Question:** What is the reason for using a sleeve for the HDD's instead of pulling the matched pipe in the areas with the HDPE?

Response: The casing is required to protect the carrier pipe and allow for future maintenance.

2. **Question:** Can engineered bore profiles please be provided based on the bend radius of the pipe being spec'd for the project? Currently the HDDs are just shown as sections under the ground, which do not account for entry and exit. This underestimates the footage required to conduct the HDD's.

Response: The contractor is to provide profiles which include, but are not limited to the following: minimum pipe elevation, entry and exit angle, and bending radii of pipeline. See Specification 330523.13 – HORIZONTAL DIRECTIONAL DRILLING for additional requirements. The profiles provided account for the minimum bend radius.

3. **Question:** Spec is calling for the pipe to be filled with water to limit buoyancy during pullback. This is not a typical practice on short bores of this nature. Is this requirement up for discussion?

Response: Please bid the requirement at this time. The purpose of requirement is to eliminate buckling stress.

4. **Question:** The spec is requiring that a minimum of 2 locate wires be pulled with each bore. Is there a spec sheet for a preferred or required wire? If there is to be a pipe installed into a casing, would it be allowable to just pull the locate wire into the casing with the carrier pipe to minimize the potential damage to the wire?

Response: The specification for tracer wires has been added to Specification Section 331100. The suggested method of installation is acceptable.

August 28, 2025

5. **Question:** If locate wire is to be used will there be a line item in the bid for the materials?

Response: Locate wire shall be subsidiary to installed cost of pipe. This has been clarified in Specification Section 331100.

6. **Question:** Will the permitting process account for a permit to draw water from streams and lakes in the relative area of the project or will there be a provided water source?

Response: The City will not charge for potable water needed for flushing/cleaning/filling the water main; however the Contractor will need to coordinate for this use. For non-potable water sources, the Contractor may consider using ponds near Glacier Bear Road. The Contractor will need to secure this permit.

7. **Question:** In the instance of contaminated mud what is the process for disposal and testing? Who will permit and secure a place for this material?

Response: The Contractor will be responsible for the means and methods for drilling mud as well as permitting for the disposal. There have been no identified PFAS samples above the groundwater cleanup level.

8. **Question:** Sheet C-318 calls for 8" HDPE & 18" HDPE SDR17 casing. Please clarify as 10 DIP is on both sides of the HDD? Will this be 2 casings in this HDD?

Response: There are two casings shown along the same profile. The 18" HDPE SDR17 casing will encase the 10" DIP. The 8" HDPE SDR will encase the 3" recirculation line.

9. **Question:** Please clarify how specification sections 220548 and 230548 should be applied for the process water pumps and piping in the pumphouse. Clearly, no pump isolation bases are indicated on the bid set drawings; provision of isolation bases would necessitate re-design of the piping layout.

Response: Isolation bases are not required for the process pumps, but flexible connectors must be provided as specified in sections 432331 and 230548. Piping isolation shall be provided as scheduled in the specifications.

10. **Question:** Reference specification section 232416 Internal Combustion Engine Exhaust Piping: Selkirk Metalbestos IPS C4 is specified for engine exhaust pipe. The engine exhaust is indicated to be 4" pipe size, which appears to be correct for a 125 kVA genset. The smallest size available for the IPS C4 product is 5", not 4". Please clarify regarding how to proceed.

August 28, 2025

Response: Specification Section 232416 has been reissued by this addendum.

11. **Question:** The Index to Specifications indicates a section 407000 Piping Appurtenances – Instrumentation for Process Systems. This section appears to be missing from the bid documents.

Response: This Specification section is not needed. It has been removed from the index. The index has been further reviewed and updated with this addendum.

ADDENDUM 1

CONTRACT DOCUMENT INDEX

TABLE OF CONTENTS

DIVISION 00 – PROCUREMENT AND CONTRACTING REQUIREMENTS

01	Advertisement for Bids
02	C-200 Instructions to Bidders
03	C-410 Bid Form for Construction Contracts
04	C-430 Bid Bond, Penal Sum Form
05	C-510 Notice of Award
06	C-520 Agreement Between Owner & Contractor, Stipulated Price
07	C-550 Notice to Proceed
08	C-610 Construction Performance Bond
09	C-615 Construction Payment Bond
10	C-620 Contractor's Application for Payment
11	C-625 Certificate of Substantial Completion
12	C-626 Notice Of Acceptability Of Work
13	C-700 Standard General Conditions of the Construction Contract
14	C-800 Supplementary Condition
15	C-940 Work Change Directive
16	C-941 Change Order
17	C-942 Field Order
18	Special Conditions

DIVISION 01 – GENERAL REQUIREMENTS

011000	Summary
012900	Payment Procedures
013100	Project Management and Coordination
013100a	Request for Information
013200	Construction Progress Documentation
013300	Submittal Procedures
014000	Quality Requirements
014200	References
015000	Temporary Facilities and Controls
017300	Execution
017700	Closeout Procedures
017823	Operation and Maintenance Data
017839	Project Record Documents
018000	AIS and BABA

DIVISION 02 – EXISTING CONDITIONS

024119	Selective Demolition
--------	----------------------

DIVISION 03 – CONCRETE

032000	Concrete Reinforcing
033000	Cast in Place Concrete

DIVISION 05 – METALS

055000	Metal Fabrications
--------	--------------------

DIVISION 07 – THERMAL AND MOISTURE PROTECTION

074116	Insulated Metal Roof Panels
074213	Insulated Metal Wall Panels

~~072119~~ ~~Foamed-in-Place Insulation~~
~~077253~~ ~~Snow Guards~~
~~078413~~ ~~Penetration Firestopping~~
079200 Joint Sealants

DIVISION 08 – OPENINGS

081113 Hollow Metal Doors and Frames

DIVISION 09 – FINISHES

092900 Gypsum Board
~~099123~~ ~~Interior Painting~~

DIVISION 13 – SPECIAL CONSTRUCTION

133419 Metal Building Systems

DIVISION 22 – PLUMBING

220100 General Plumbing Requirements
220500 Common Work Results for Plumbing
220523 Plumbing Piping Valves and Specialties
220529 Hangers and Supports for Plumbing Piping and Equipment
220548 Vibration and Seismic Controls for Plumbing Piping and Equipment
220553 Identification for Plumbing Piping and Equipment
220700 Plumbing Insulation
221116 Domestic Water Piping
221316 Sanitary Waste and Vent Piping
221319 Sanitary Waste Piping Specialties
~~223000~~ ~~Plumbing~~
223300 Electric, Domestic-Water Heaters
224000 Plumbing Fixtures
~~224216.16~~ Commercial Sinks

DIVISION 23 – HEATING, VENTILATING, AND AIR CONDITIONING

230100 General Mechanical Requirements
230548 Mechanical Sound, Vibration, and Seismic Control
230553 Identification for HVAC Piping and Equipment
230593 Testing, Adjusting and Balancing for HVAC
230700 HVAC Insulation
~~230900~~ ~~HVAC Controls and Sequence of Operations~~
~~230993~~ ~~Sequence of Operations for HVAC Controls~~
231113 Facility Fuel-Oil Piping
231323 Facility Aboveground Fuel-Oil Storage Tanks
232416 Internal-Combustion Engine Exhaust Piping
233100 HVAC Ducts and Casings
233300 Air Duct Accessories
233400 HVAC Fans
233700 Air Outlets and Inlets
~~238239.19~~ Electric Heaters

DIVISION 26 – ELECTRICAL

260519 Low-Voltage Electrical Power Conductors and Cables
260522 Heat Trace Cables

260523	Control-Voltage Electrical Power Cables
260526	Grounding and Bonding for Electrical Systems
260529	Hangers and Supports for Electrical Systems
260533.13	Conduits for Electrical Systems
260533.16	Boxes and Covers for Electrical Systems
260543	Underground Ducts and Raceways for Electrical Systems
260544	Sleeves and Seals for Electrical Raceways and Cabling
260553	Identification for Electrical Systems
262213	Low Voltage Distribution Transformers
262416	Panelboards
262713	Electricity Metering
262726	Wiring Devices
262816	Enclosed Switches and Circuit Breakers
262913.03	Manual and Magnetic Motor Controllers
262923	Variable-Frequency Motor Controllers
263213.13	Diesel-Engine-Driven Generator Sets
263600	Transfer Switches
265000	Lighting
265613	Lighting Poles and Standards

DIVISION 27 – COMMUNICATIONS

270528	Pathways for Communications Systems
271513	Communications Copper Horizontal Cabling

DIVISION 31 – EARTHWORK

310000	Erosion, Sediment, and Pollution Control
310000a	ESCP Narrative
311000	Site Clearing
312000	Earth Moving
312319	Dewatering

DIVISION 32 – EXTERIOR IMPROVEMENTS

321216	Asphalt Paving
323113	Chain Link Fences and Gates
329200	Turf and Grasses

DIVISION 33 – UTILITIES

330523.13	Horizontal Directional Drilling
331000 331100	Water Distribution
331613	Potable Water Storage Tank
333113	Sanitary Utility Sewerage Piping
334100	Storm Utility Drainage Piping

DIVISION 40 – PROCESS

400500	Basic Requirements
400507	Hangers and Supports for Process Piping
400520	Plant Pipe and Fittings
400551	Plant Valves
400597	Identification
406000	Process Control System
406000a	Process Control System-Attachment A- Control Narrative

City and Borough of Yakutat – Airport Water Extension

INDEX TO
SPECIFICATIONS

406000b Process Control System-Attachment B- IO List
~~407000 Piping Appurtenances Instrumentation for Process Systems~~
407113 Electromagnetic Flow Meter
407521 Chlorine Analyzer

DIVISION 43 – PROCESS EQUIPMENT

432331 Vertical and Horizontal Centrifugal Booster Pumps

DIVISION 46 – WATER AND WASTEWATER EQUIPMENT

463300 Liquid Chemical Feed Equipment

END OF INDEX

Formatted: Line spacing: Multiple 1.2 li, Hyphenate

ADDENDUM 1

TECHNICAL
SPECIFICATIONS

SECTION 23 24 16 - INTERNAL-COMBUSTION ENGINE EXHAUST PIPING

PART 1 - GENERAL

1.01 BUY AMERICAN REQUIREMENTS

A. Provide certificates to show that all products meet the following requirements.

1. American Iron and Steel (AIS)
2. Build America, Buy America Act B.

1.02 SUMMARY

A. Section Includes:

1. Engine exhaust.
2. Equipment drains and overflows.
3. Unions and flanges.
4. Pipe hangers and supports.

B. Related Sections:

1. Section 23 05 53 - Identification for HVAC Piping and Equipment: Product requirements for pipe identification for placement by this section.
2. Section 23 07 00 - HVAC Insulation: Product requirements for Piping Insulation for placement by this section.

1.03 REFERENCES

A. American Society of Mechanical Engineers:

1. ASME B16.3 - Malleable Iron Threaded Fittings.
2. ASME B16.4 - Gray Iron Threaded Fittings.
3. ASME B16.18 - Cast Copper Alloy Solder Joint Pressure Fittings.
4. ASME B16.22 - Wrought Copper and Copper Alloy Solder Joint Pressure Fittings.
5. ASME B31.1 - Power Piping.
6. ASME B31.9 - Building Services Piping.
7. ASME Section IX - Boiler and Pressure Vessel Code - Welding and Brazing Qualifications.

B. ASTM International:

1. ASTM A53/A53M - Standard Specification for Pipe, Steel, Black and HotDipped, Zinc-Coated, Welded and Seamless.
2. ASTM A234/A234M - Standard Specification for Piping Fittings of Wrought Carbon Steel and Alloy Steel for Moderate and High Temperature Service.
3. ASTM A395/A395M - Standard Specification for Ferritic Ductile Iron PressureRetaining Castings for Use at Elevated Temperatures.

4. ASTM A536 - Standard Specification for Ductile Iron Castings.
5. ASTM B32 - Standard Specification for Solder Metal.
6. ASTM B88 - Standard Specification for Seamless Copper Water Tube.
7. ASTM F708 - Standard Practice for Design and Installation of Rigid Pipe Hangers.
8. ASTM F1476 - Standard Specification for Performance of Gasketed Mechanical Couplings for Use in Piping Applications.

C. American Welding Society:

1. AWS D1.1 - Structural Welding Code - Steel.

D. Manufacturers Standardization Society of the Valve and Fittings Industry:

2. MSS SP 58 - Pipe Hangers and Supports - Materials, Design and Manufacturer.
3. MSS SP 69 - Pipe Hangers and Supports - Selection and Application.
4. MSS SP 70 - Cast Iron Gate Valves, Flanged and Threaded Ends.
5. MSS SP 80 - Bronze Gate, Globe, Angle and Check Valves.
6. MSS SP 89 - Pipe Hangers and Supports - Fabrication and Installation Practices.
7. MSS SP 110 - Ball Valves Threaded, Socket-Welding, Solder Joint, Grooved and Flared Ends.

1.04 SYSTEM DESCRIPTION

- A. Where more than one piping system material is specified, provide compatible system components and joints. Use non-conducting dielectric connections whenever jointing dissimilar metals in open systems.
- B. Provide flanges, union, and couplings at locations requiring servicing. Use unions, flanges, and couplings downstream of valves and at equipment or apparatus connections. Do not use direct welded or threaded connections to valves, equipment or other apparatus.
- C. Provide pipe hangers and supports in accordance with ASME B31.1, ASME B31.9, ASTM F708, MSS SP 58, MSS SP 69, and MSS SP 89.
- D. Use gate or ball valves for shut-off and to isolate equipment.
- E. Use 3/4 inch ball valves with cap for drains at main shut-off valves, low points of piping, bases of vertical risers, and at equipment. Pipe to floor.
- F. Flexible Connectors: Use at or near engine driven equipment where piping configuration does not absorb vibration.

1.05 SUBMITTALS

- A. Section 01 33 00 - Submittal Procedures: Submittal procedures.

- B. Shop Drawings: Indicate schematic layout of piping system, including equipment, critical dimensions, and sizes.
- C. Product Data:
 - 1. Piping: Submit data on pipe materials, fittings, and accessories. Submit manufacturer's catalog information.
 - 2. Valves: Submit manufacturers catalog information with valve data and ratings for each service.
 - 3. Hangers and Supports: Submit manufacturers catalog information including load capacity.
- D. Design Data: Indicate pipe size. Indicate load carrying capacity of trapeze, multiple pipe, and riser support hangers.
- E. Test Reports: Indicate results of piping system pressure test.
- F. Manufacturer's Installation Instructions: Submit hanging and support methods, joining procedures and isolation.
- G. Manufacturer's Certificate: Certify products meet or exceed specified requirements.
- H. Welders' Certificate: Include welders' certification of compliance with ASME Section IX.

1.06 CLOSEOUT SUBMITTALS

- A. Section 01 77 00 - Closeout Procedures: Closeout procedures.
- B. Project Record Documents: Record actual locations of valves, equipment and accessories.
- C. Operation and Maintenance Data: Submit instructions for installation and changing components, spare parts lists, exploded assembly views.

1.07 QUALITY ASSURANCE

- A. Perform Work in accordance with ASME B31.1 code for installation of piping systems and ASME Section IX for welding materials and procedures.
- B. Perform Work in accordance with AWS D1.1 for welding hanger and support attachments to building structure.
- C. Maintain one copy of each document on site.

1.08 QUALIFICATIONS

- A. Manufacturer: Company specializing in manufacturing products specified in this section with minimum three years documented experience.

- B. Fabricator or Installer: Company specializing in performing Work of this section with minimum three years documented experience.
- C. Design piping system under direct supervision of Professional Engineer experienced in design of this Work and licensed in State of Alaska.

1.09 PRE-INSTALLATION MEETINGS

- A. Section 01 31 00 – Project Management and Coordination: Pre-installation meeting.
- B. Convene minimum one week prior to commencing work of this section.

1.10 DELIVERY, STORAGE, AND HANDLING

- A. Section 01 40 00 - Quality Requirements: Product storage and handling requirements.
- B. Accept valves on site in shipping containers with labeling in place. Inspect for damage.
- C. Provide temporary end caps and closures on piping and fittings. Maintain in place until installation.
- D. Protect piping systems from entry of foreign materials by temporary covers, completing sections of the Work, and isolating parts of completed system.

1.11 FIELD MEASUREMENTS

- A. Verify field measurements prior to fabrication.

PART 2 - PRODUCTS

2.01 ENGINE EXHAUST PIPE

- A. Steel Pipe: ASTM A53/A53M, Schedule 40, 0.375 inch wall for sizes 12 inch and larger, black.
 - 1. Fittings: ASME B16.3, malleable iron or ASTM A234/A234M, forged steel welding type.
 - 2. Joints: Threaded for pipe 2 inch and smaller; welded for pipe 2-1/2 inches and larger.
 - 3. Insulation: Provide in accordance with section 230700.

2.02 EQUIPMENT DRAINS AND OVERFLOWS

- A. Steel Pipe: ASTM A53/A53M Schedule 40, galvanized.
 - 1. Fittings: ASME B16.3, malleable iron or ASME B16.4, cast iron.
 - 2. Joints: Threaded for pipe 2 inch and smaller; flanged for pipe 2-1/2 inches and larger.

B. Steel Pipe: ASTM A53/A53M Schedule 40, galvanized, cut grooved ends.

1. Fittings: ASTM A395/A395M and ASTM A536 ductile iron, or ASTM A234/A234M carbon steel, grooved ends.
2. Joints: Grooved mechanical couplings meeting ASTM F1476.
 - a. Housing Clamps: ASTM A395/A395M and ASTM A536 ductile iron, hot dipped galvanized, compatible with steel piping sizes, rigid or flexible type.
 - b. Gasket: Elastomer composition for operating temperature range from 86 degrees F to 230 degrees F.
 - c. Accessories: Stainless steel bolts, nuts, and washers.

C. Copper Tubing: ASTM B88, Type K, drawn.

1. Fittings: ASME B16.18, cast brass, or ASME B16.22 solder wrought copper.
2. Joints: ASTM B32, Alloy Grade Sb5 tin-antimony, or Alloy Grade Sn95 tin silver, lead free solder.

2.03 UNIONS AND FLANGES

A. Unions for Pipe 2 inches and Smaller:

1. Ferrous Piping: Class 150, malleable iron, threaded.
2. Copper Piping: Class 150, bronze unions with soldered.
3. Dielectric Connections: Union with galvanized or plated steel threaded end, copper solder end, water impervious isolation barrier.

B. Flanges for Pipe 2-1/2 inches and Larger:

1. Ferrous Piping: Class 150, forged steel, slip-on flanges.
2. Copper Piping: Class 150, slip-on bronze flanges.
3. Gaskets: 1/16 inch thick preformed neoprene gaskets.

2.04 BALL VALVES

A. Manufacturers:

1. Hammond Valve Model 8201 or approved equal.
2. Substitutions: 01 40 00 - Quality Requirements.

B. 2 inches and Smaller: MSS SP 110, 400 psi WOG, two piece bronze body, chrome plated brass ball, regular port, teflon seats, blow-out proof stem, press ends, lever handle.

2.05 PIPE HANGERS AND SUPPORTS

A. Manufacturers:

1. Grinnell or approved equal.

2. Substitutions: 01 40 00 - Quality Requirements.

- B. Conform to ASME B31.1, ASME 31.9, ASTM F708, MSS SP 58, MSS SP 69, and MSS SP 89.
- C. Hangers for Pipe Sizes 1/2 to 1-1/2 inch: Malleable iron, adjustable swivel, split ring.
- D. Hangers for Pipe Sizes 2 to 4 inches: Carbon steel, adjustable, clevis.
- E. Hangers for Pipe Sizes 6 inches and Larger: Adjustable steel yoke, cast iron roll, double hanger.
- F. Wall Support for Pipe Sizes 4 inches and Larger: Welded steel bracket and wrought steel clamp with adjustable steel yoke and cast iron roll. G. Vertical Support: Steel riser clamp.
- H. Floor Support for Pipe 4 inches and Smaller: Cast iron adjustable pipe saddle, lock nut, nipple, floor flange, and concrete pier or steel support.
- I. Floor Support for Pipe Sizes 6 inches and Larger: Adjustable cast iron roll and stand, steel screws, and concrete pier or steel support.
- J. Copper Pipe Support: Carbon steel rings, adjustable, copper plated.
- K. Hanger Rods: Mild steel threaded both ends, threaded one end, or continuous threaded.
- L. Inserts: Malleable iron case of galvanized steel shell and expander plug for threaded connection with lateral adjustment, top slot for reinforcing rods, lugs for attaching to forms; size inserts to suit threaded hanger rods.

PART 3 - EXECUTION

3.01 PREPARATION

- A. Ream pipe and tube ends. Remove burrs.
- B. Remove scale and dirt on inside and outside before assembly.
- C. Prepare piping connections to equipment with flanges or unions.
- D. Keep open ends of pipe free from scale and dirt. Protect open ends with temporary plugs or caps.

3.02 INSTALLATION - PIPE HANGERS AND SUPPORTS

- A. Install in accordance with ASME B31.1, ASTM F708, and MSS SP 89.
- B. Support horizontal piping as scheduled.

- C. Install hangers to provide minimum 1/2 inch space between finished covering and adjacent work.
- D. Place hangers within 12 inches of each horizontal elbow.
- E. Use hangers with 1-1/2 inch minimum vertical adjustment. Design hangers for pipe movement without disengagement of supported pipe.
- F. Support vertical piping at every floor. Support riser piping independently of connected horizontal piping.
- G. Provide sheet lead packing between hanger or support and piping.
- H. Provide clearance in hangers and from structure and other equipment for installation of insulation and access to valves and fittings.
- I. Install pipe hangers and supports in accordance with Section 22 05 29.

3.03 INSTALLATION - ABOVE GROUND PIPING SYSTEMS

- A. Install engine exhaust piping in accordance with ASME B31.1.

3.04 FIELD QUALITY CONTROL

- A. Section 01 40 00 - Quality Requirements: Field inspecting, testing, adjusting, and balancing.
- B. Test engine exhaust piping in accordance with ASME B31.1.
- C. Pipe Hanger Spacing:

PIPE SIZE Inches	COPPER TUBING MAXIMUM HANGER SPACING Feet	STEEL PIPE MAXIMUM HANGER SPACING Feet	COPPER TUBING HANGER ROD DIAMETER Inches	STEEL PIPE HANGER ROD DIAMETER Inches
1/2	5	7	3/8	3/8
3/4	5	7	3/8	3/8
1	6	7	3/8	3/8
1-1/4	7	7	3/8	3/8
1-1/2	8	9	3/8	3/8
2	8	10	3/8	3/8

2-1/2 (Note 1)	9	11	1/2	1/2
3	10	12	1/2	1/2
4	12	14	1/2	5/8
5	13	16	1/2	5/8
6	14	17	5/8	3/4



D. Note 1: Refer to manufacturer's recommendations for grooved end piping systems.

END OF SECTION

ADDENDUM 1

DRAWINGS

IF THIS BAR DOES NOT MEASURE EXACTLY ONE INCH, THE SCALE OF THIS DRAWING HAS BEEN ALTERED DURING IT'S PRODUCTION, AFFECTING ALL LABELED SCALES

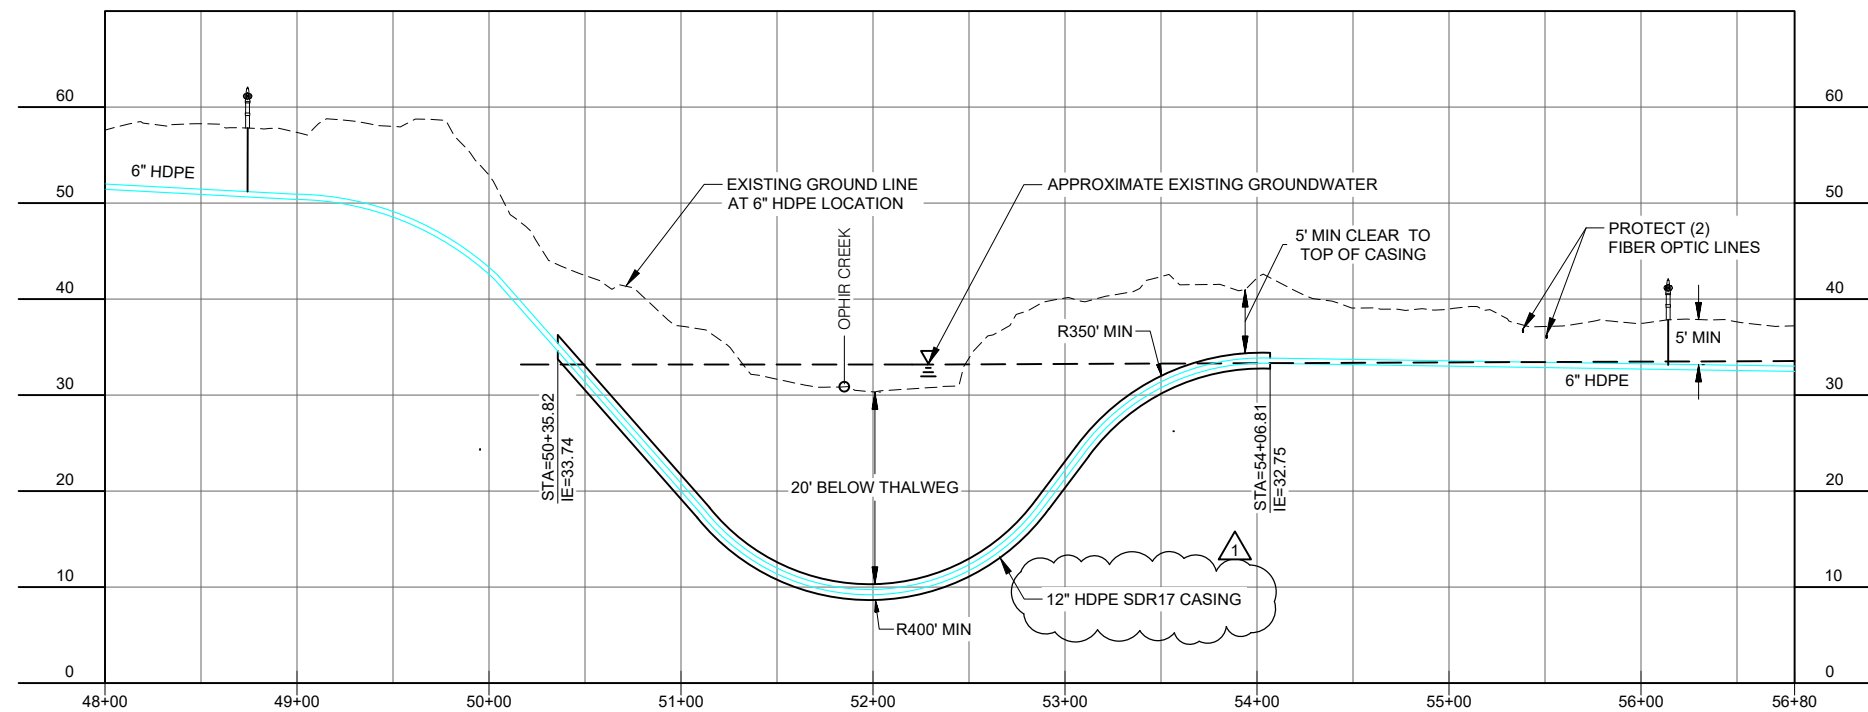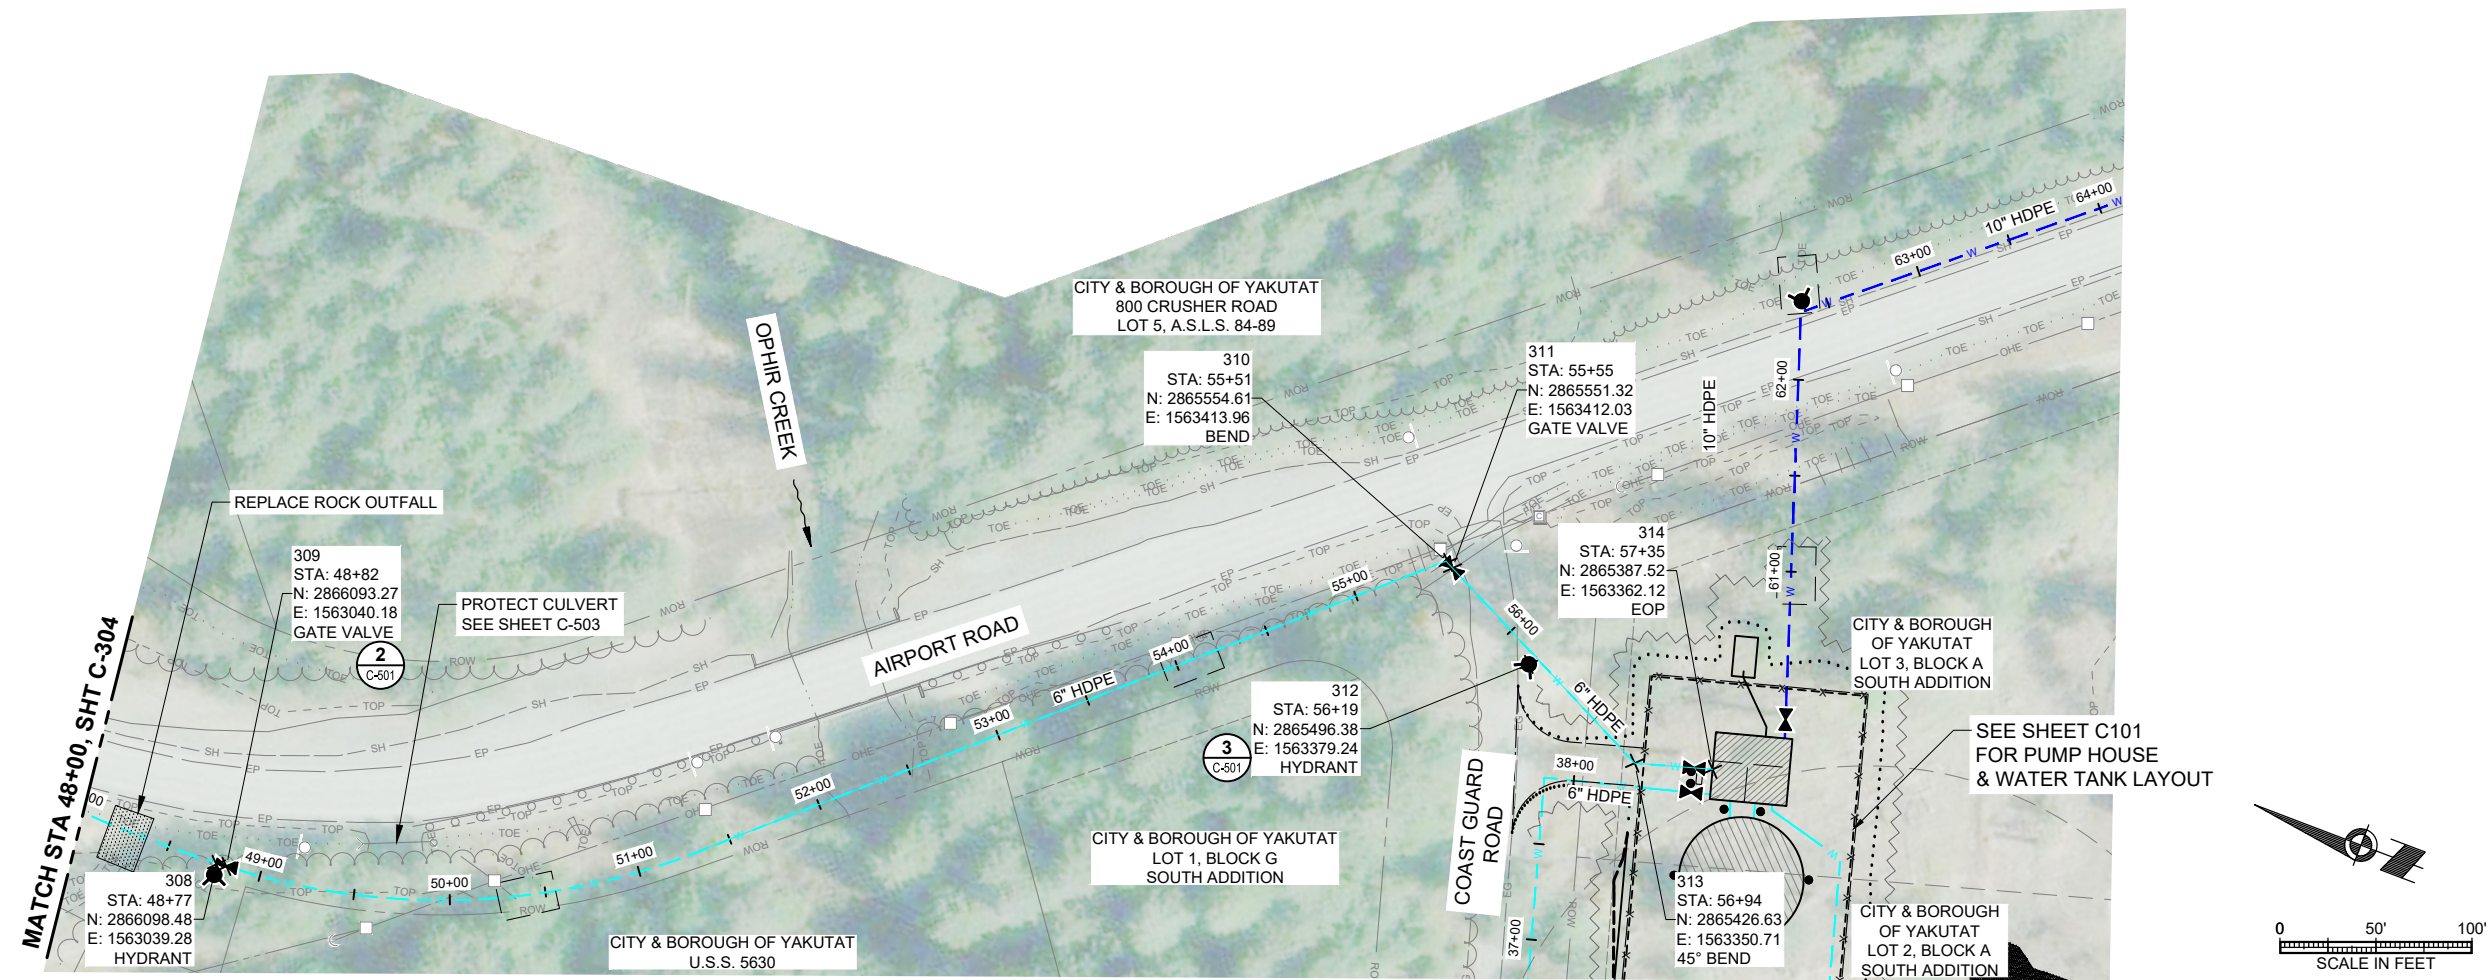[illegible]

CONSULTANT:



Juneau, AK
9109 Mendenhall Mall Rd, Ste. 4
Juneau, AK 99801
Phone: 907.780.6060
Fax: 907.586.3771
AECC163270



PROJECT :
CITY & BOROUGH OF YAKUTAT
WATER SYSTEM EXTENSION

YAKUTAT, ALASKA


SHEET TITLE :

**PLAN AND PROFILE -
AIRPORT ROAD (2 OF 14)**

DESIGN	AM
DRAWN	HR
CHECKED	KA
DATE	04-16-202


PROJECT No.	10297.24002
SHEET NUMBER	

C-305

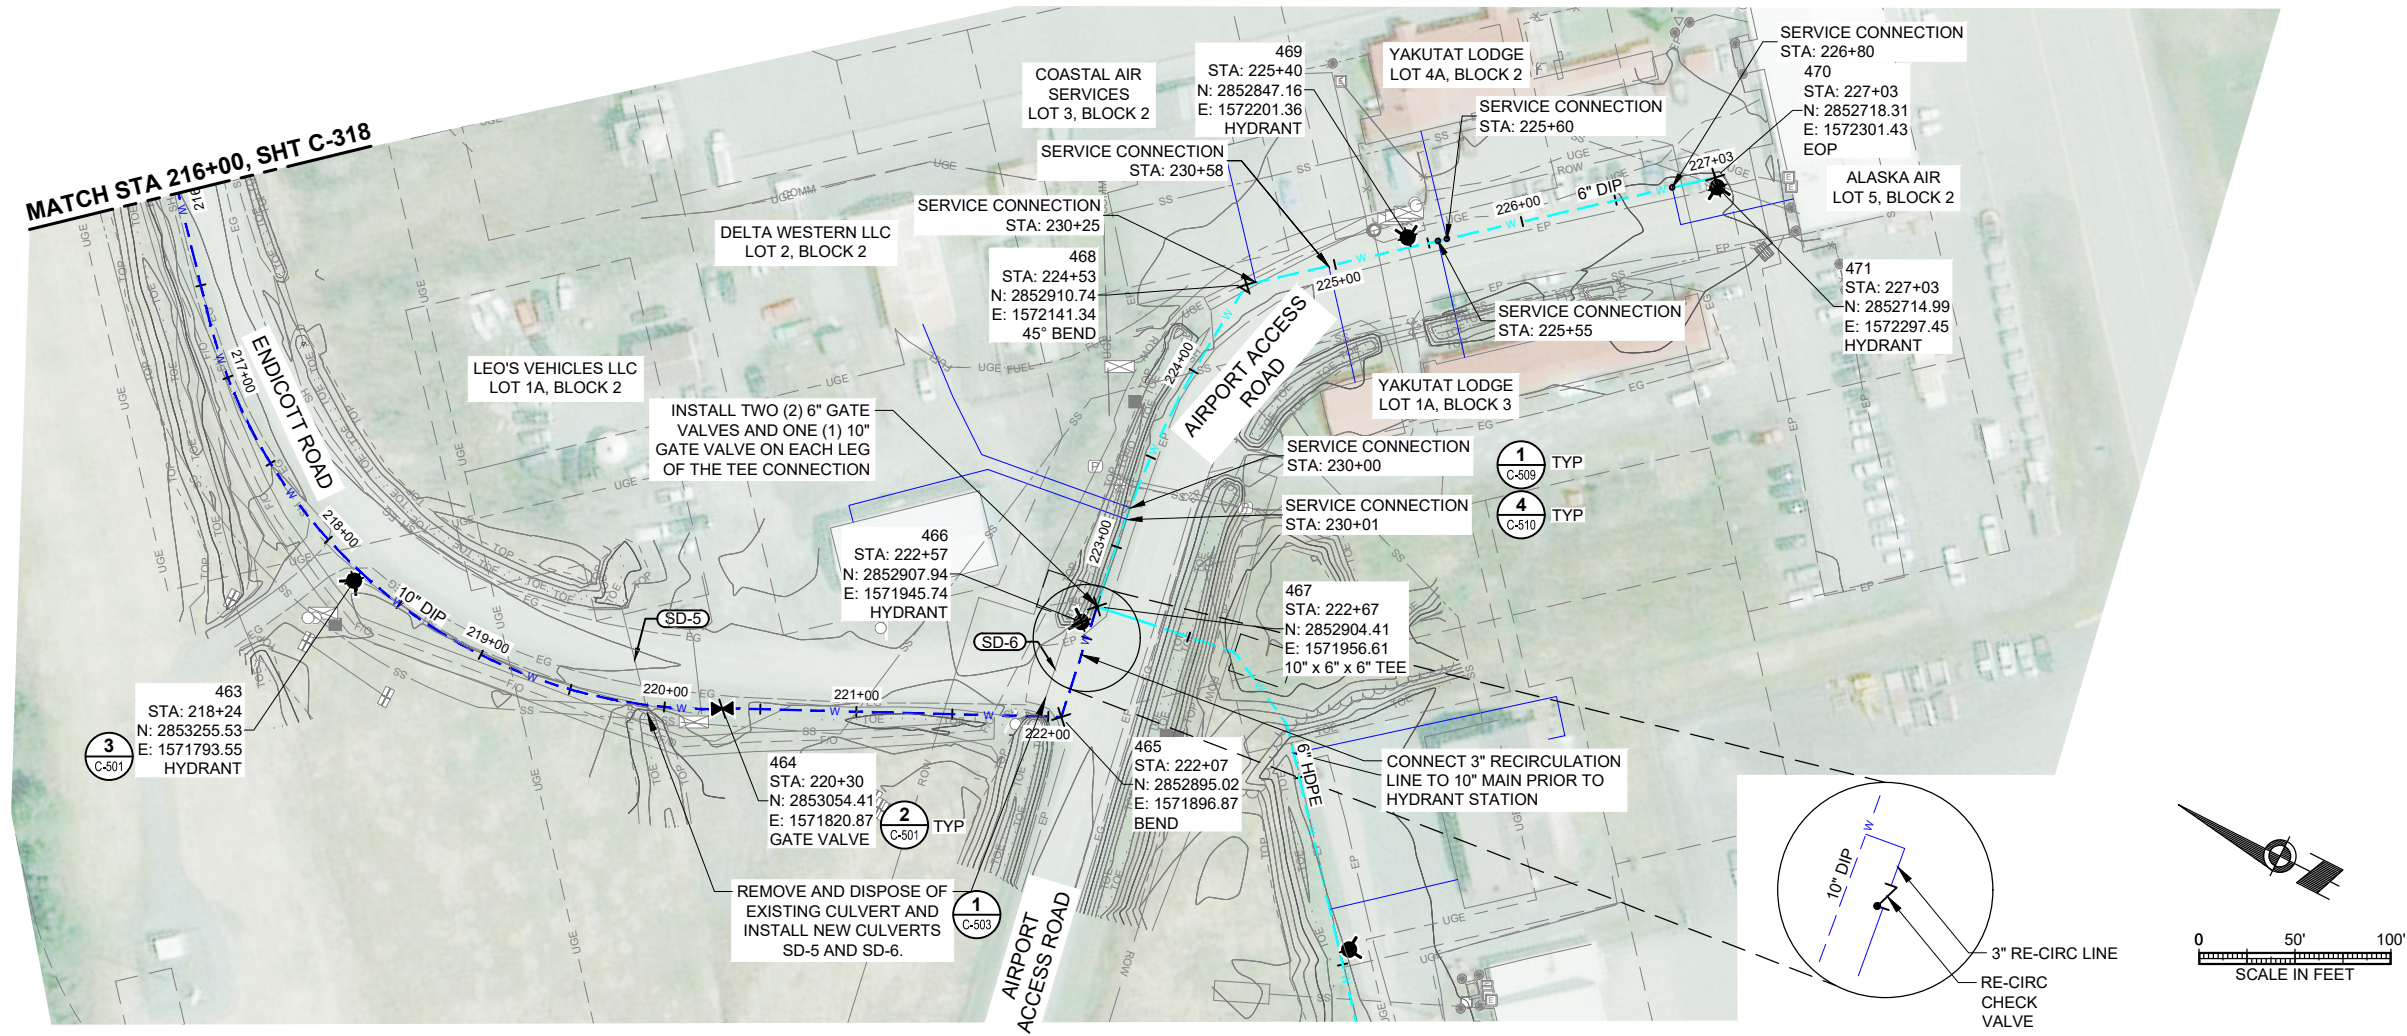

NOTES:

1. IN THE EVENT THAT THE SEWER LINE IS FOUND IN CONFLICT WITH PROPOSED WATER MAIN ELEVATION, INSTALL WATER BELOW SEWER AS SHOWN IN DETAIL 3/C-503.
2. SOILS EXCAVATED FROM STA: 222+75 TO STA: 23+25 SHALL BE SEGREGATED AND DISPOSED OF IN ACCORDANCE WITH THE CONTAMINATED MATERIALS MANAGEMENT PLAN, UNLESS MATERIAL IS SAMPLED AND DETERMINED TO BE BELOW THE APPLICABLE CLEANUP LIMITS.

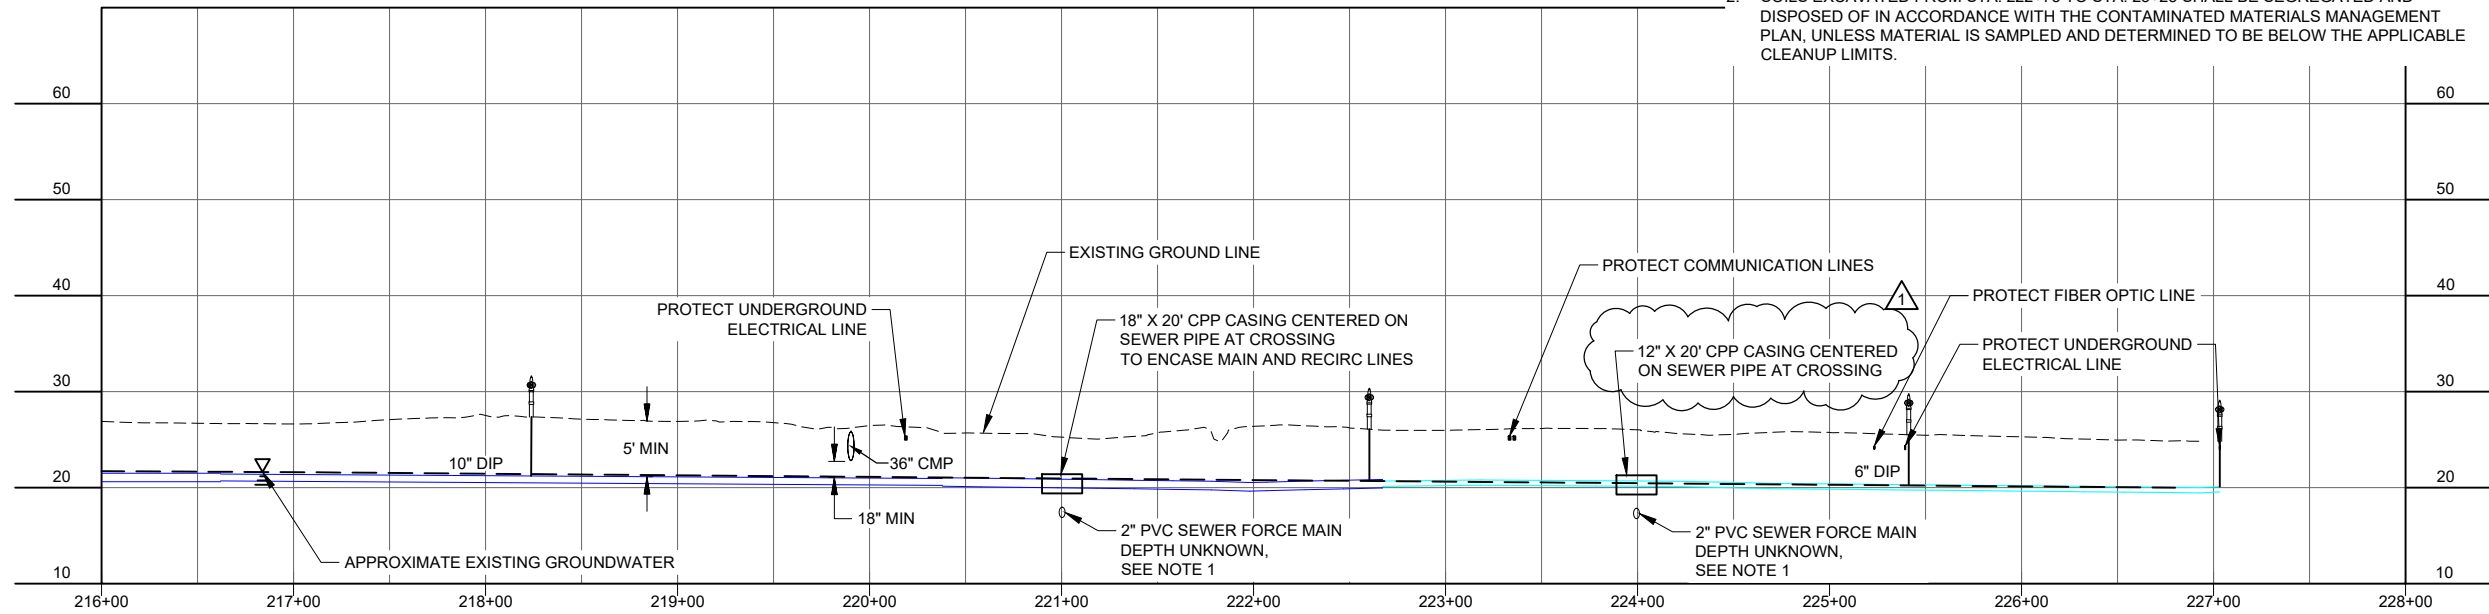

--	--	
CONSULTANT :



Juneau, AK
9080 Mendota Rd. Ste. 4
Juneau, AK 99801
Phone: 907.586.3771
Fax: 907.586.3771
AEC 163270




PROJECT :
**CITY & BOROUGH OF YAKUTAT
WATER SYSTEM EXTENSION**

YAKUTAT, ALASKA

SHEET TITLE :
**PLAN AND PROFILE -
ENDCOTT ROAD TO
AIRPORT ACCESS ROAD**

1" IF THIS BAR DOES NOT MEASURE EXACTLY ONE INCH, THE SCALE OF THIS DRAWING HAS BEEN ALTERED DURING IT'S PRODUCTION, AFFECTING ALL LABELED SCALES

N:\Projects\10297_24002_C320_Airport_Wtr_Ext\ICOLD\250505m304_Original Drawings\10297_24002_C-Plan\Profile\10297_24002_C-320.dwg 08/27/2025 1:24 PM

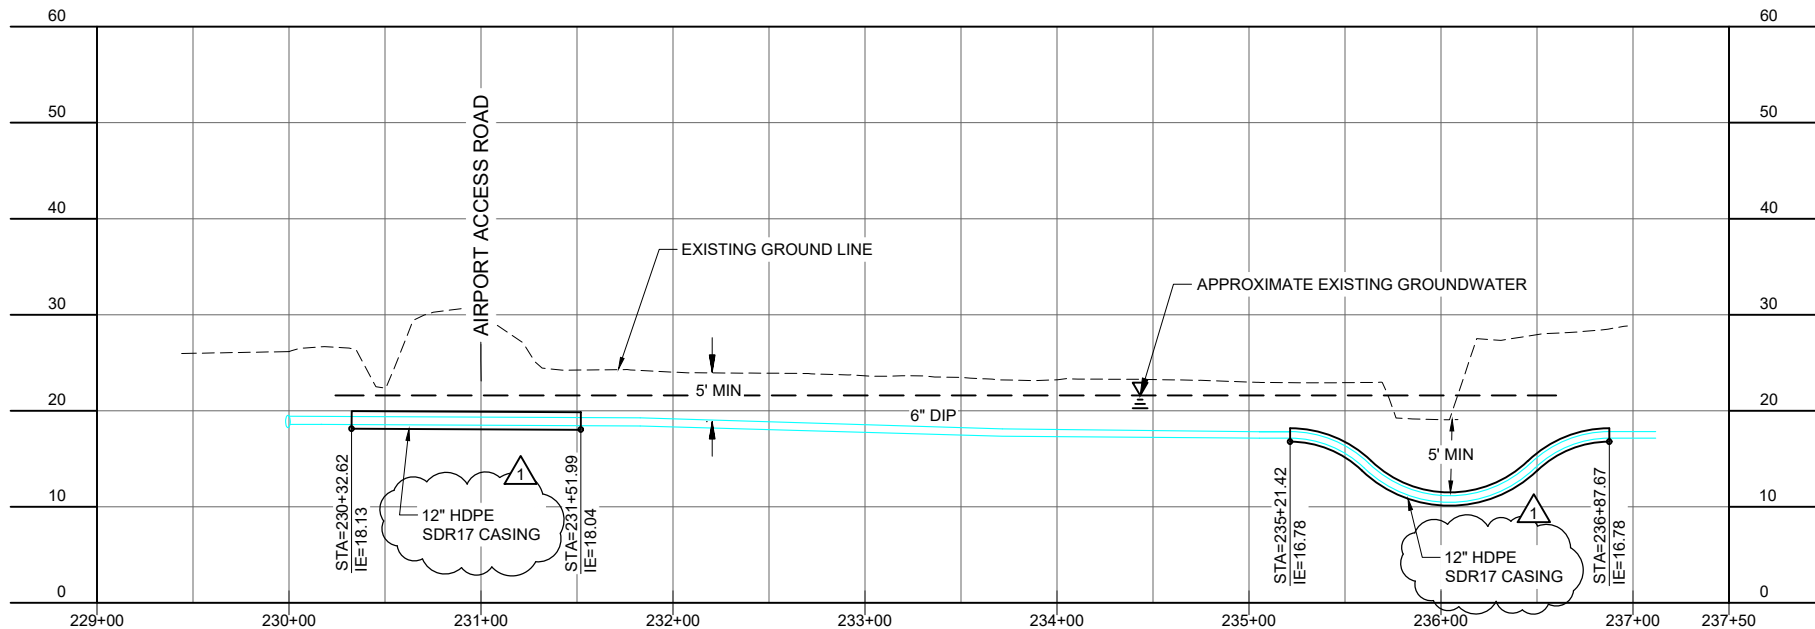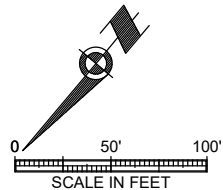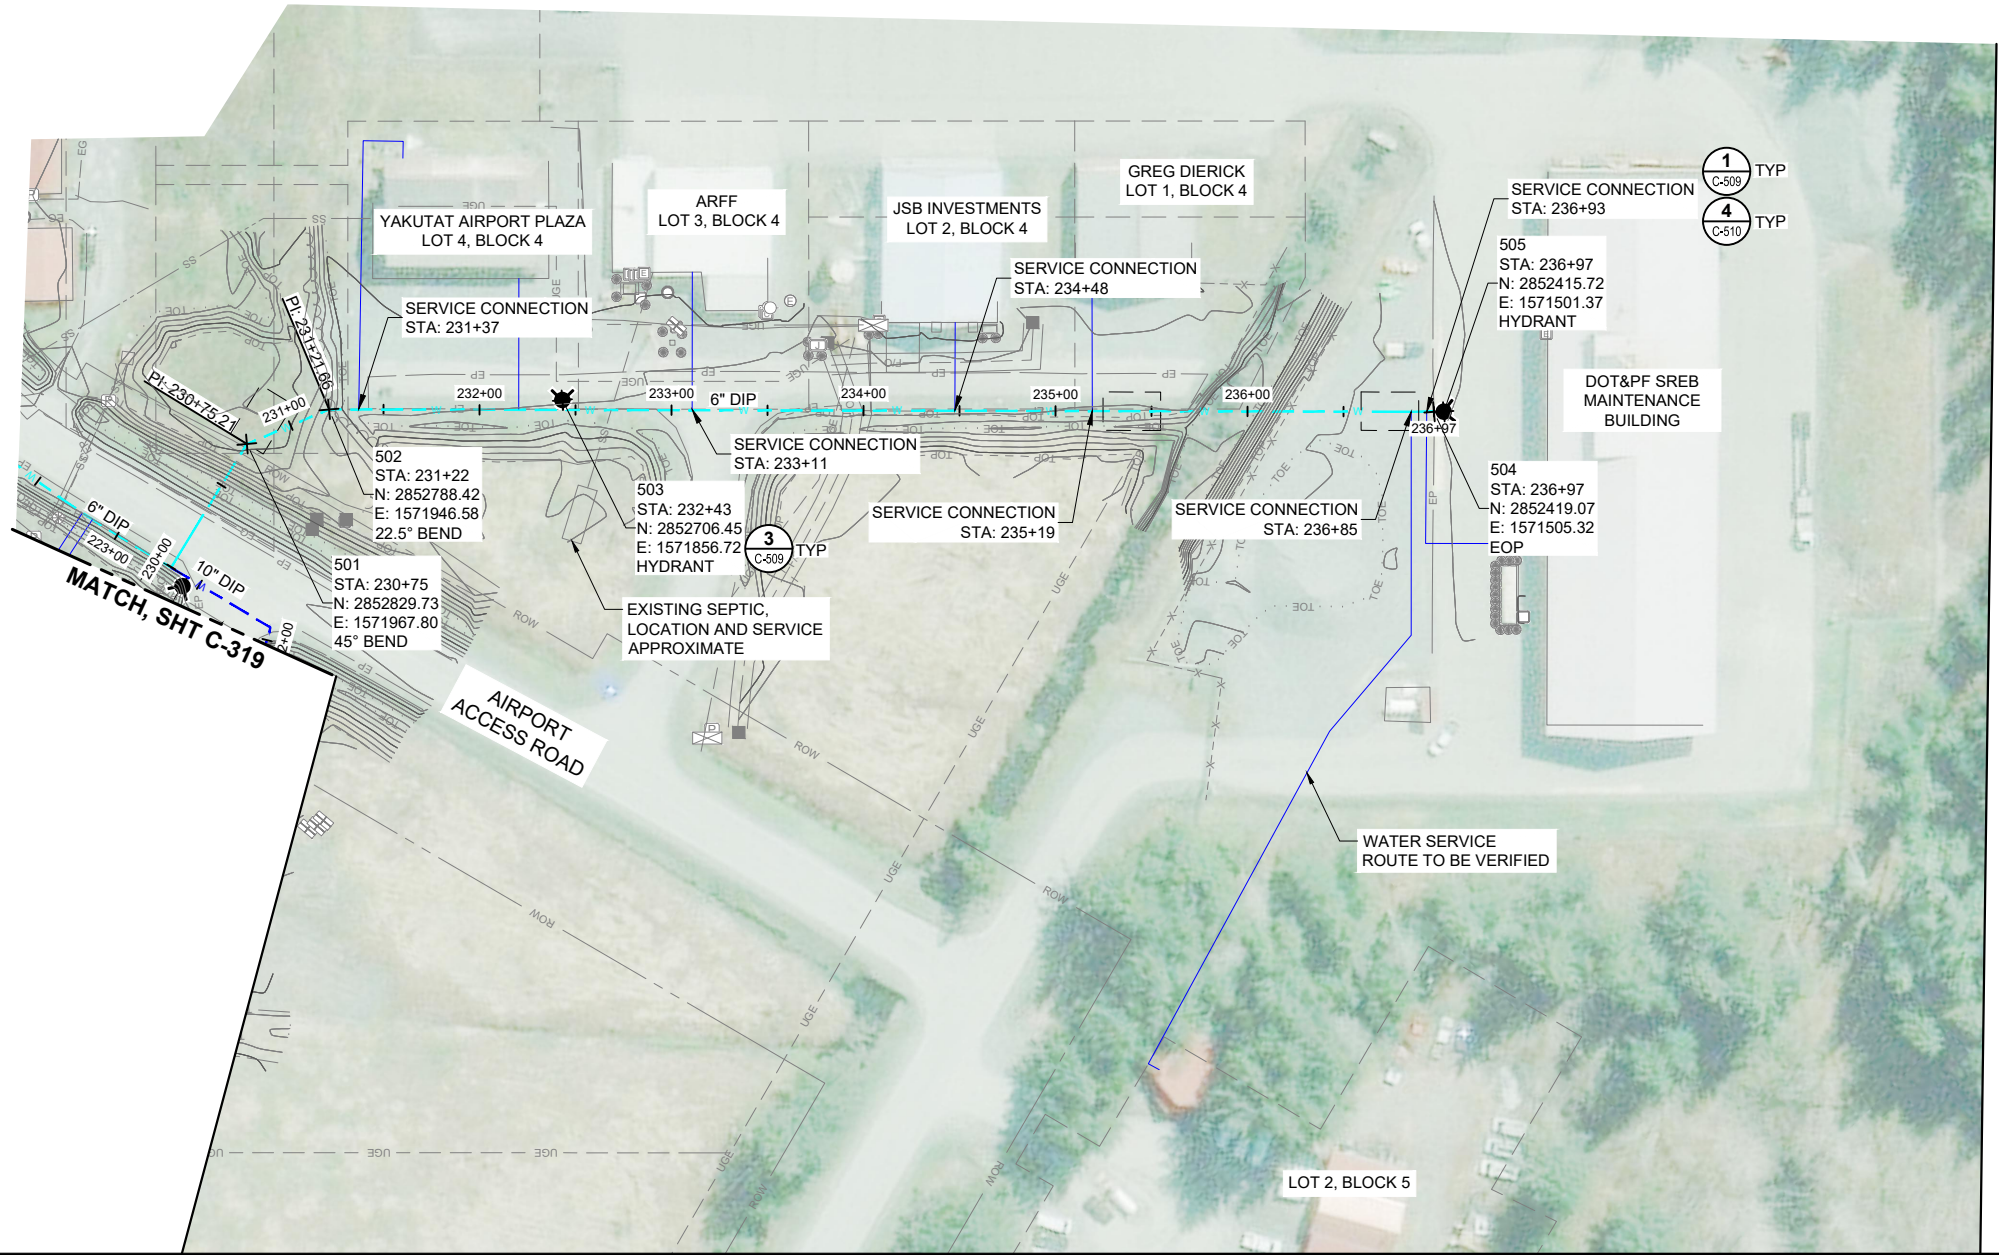

REVISIONS		
No.	Date	Item
1	08/27/2025	ADDENDUM No. 1

CONSULTANT :



Juneau, AK

9100 Mendota Rd. Ste. 4
Juneau, AK 99801
Phone: 907.586.3771
Fax: 907.586.3771
AEC 163270



PROJECT :

CITY & BOROUGH OF YAKUTAT

WATER SYSTEM EXTENSION

YAKUTAT, ALASKA

SHEET TITLE :

PLAN AND PROFILE -

AIRPORT ACCESS ROAD

DESIGN	AMN
DRAWN	HRB
CHECKED	KAB
DATE	04-16-2025


PROJECT No.

10297.24002

SHEET NUMBER


C-320

1" IF THIS BAR DOES NOT MEASURE EXACTLY ONE INCH, THE SCALE OF THIS DRAWING HAS BEEN ALTERED DURING IT'S PRODUCTION, AFFECTING ALL LABELED SCALES. M:\Projects\10297.24002\DWG_Export_Vir_Ext\ICOLD\250505m00d_Original Drawings\10297.24002\C-DETAILS: C-501_Aug 26, 2025 1:32 PM

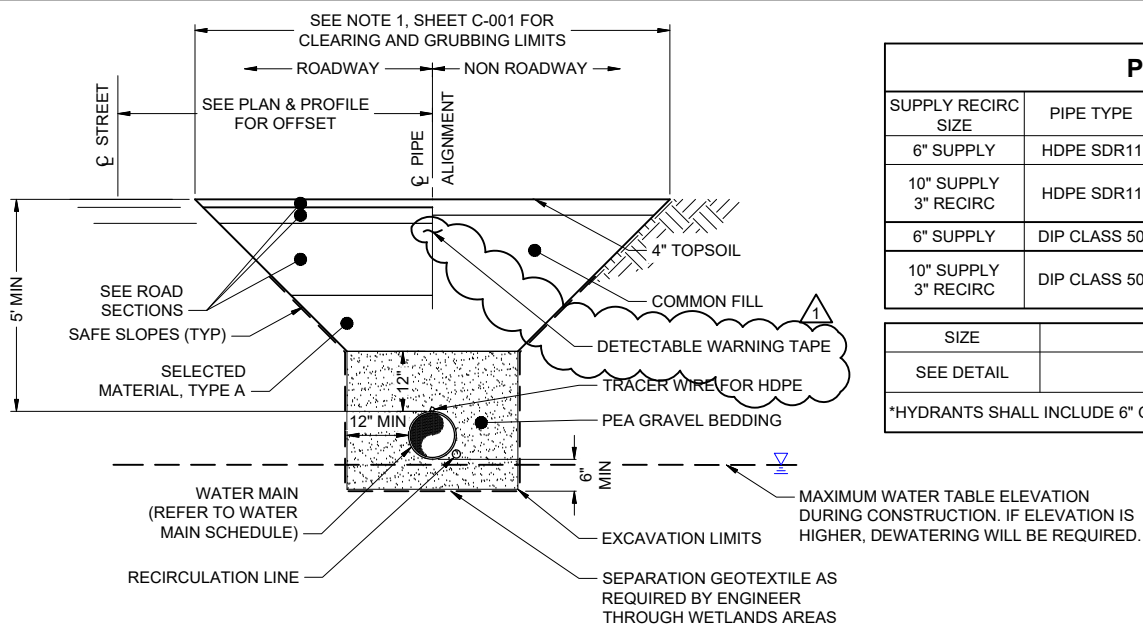


1 TYPICAL TRENCH SECTION

C-501 SCALE: N.T.S

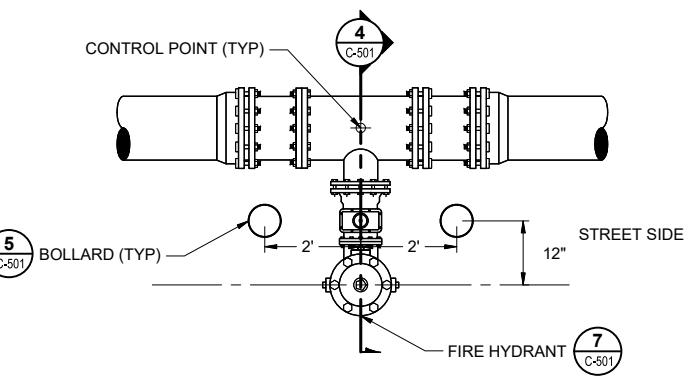

3 DETAIL: FIRE HYDRANT PLAN

C-501 SCALE: N.T.S

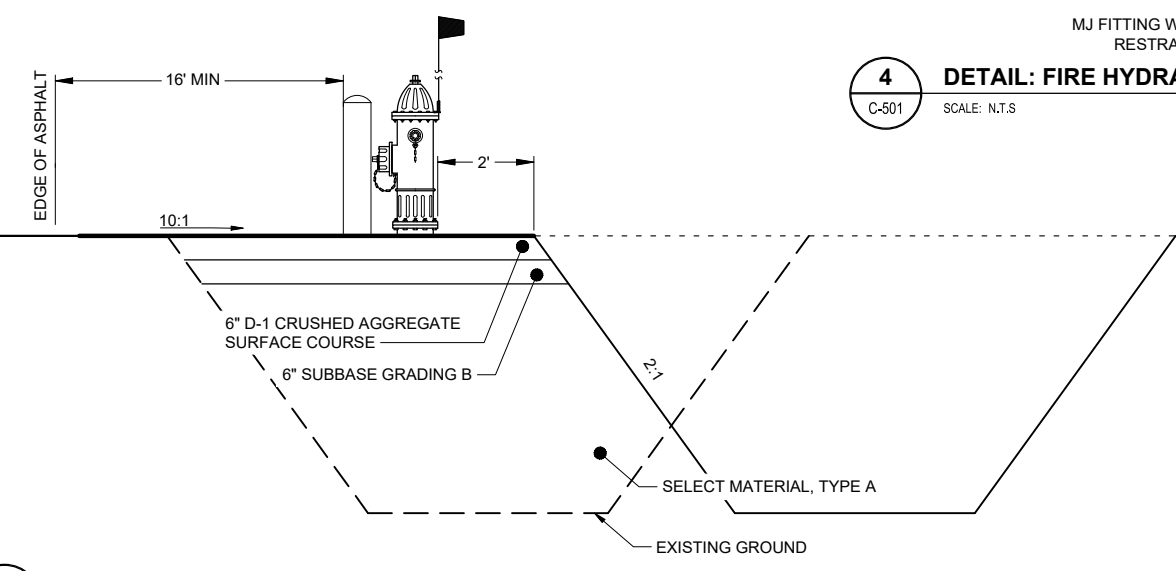


6 DETAIL: HYDRANT WIDENING SECTION

C-501 SCALE: N.T.S

PROPOSED WATER MAIN SCHEDULE				
SUPPLY RECIRC SIZE	PIPE TYPE	LOCATION	LENGTH (L.F.)	GATE VALVE QUANTITY
6" SUPPLY	HDPE SDR11	STA 10+00 TO 38+79 AND 40+37 TO 57+27	4600	15
10" SUPPLY 3" RECIRC	HDPE SDR11	STA 60+13 TO STA 197+17	13740	25
6" SUPPLY	DIP CLASS 50	STA 222+67 TO 227+03 AND 230+00 TO 236+97	1200	0
10" SUPPLY 3" RECIRC	DIP CLASS 50	STA 197+67 TO 222+67	2600	5


SIZE	DESCRIPTION	QUANTITY (EACH)
SEE DETAIL	HYDRANT	31

*HYDRANTS SHALL INCLUDE 6" GATE VALVES

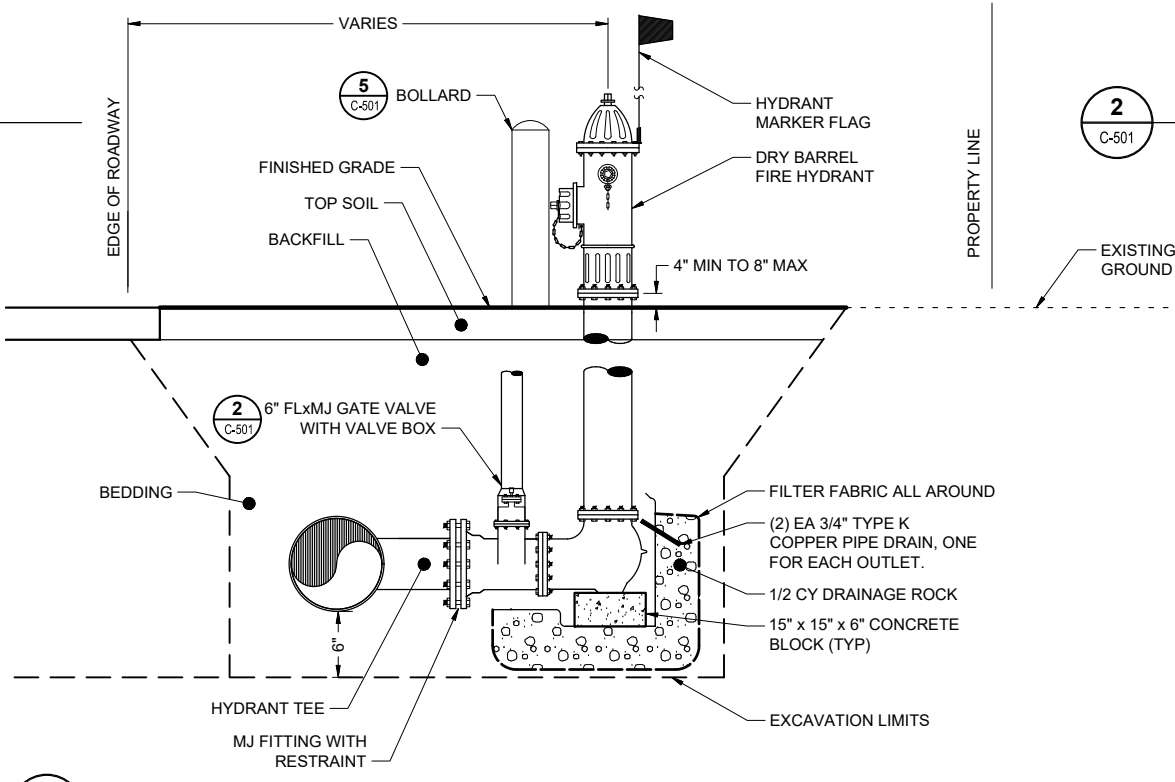


4 DETAIL: FIRE HYDRANT SECTION

C-501 SCALE: N.T.S

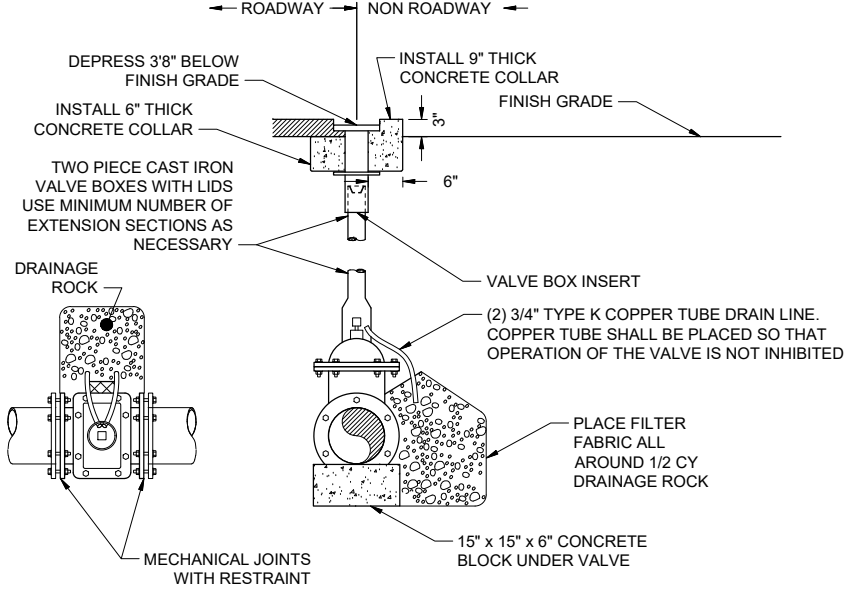


2 DETAIL: GATE VALVE

C-501 SCALE: N.T.S

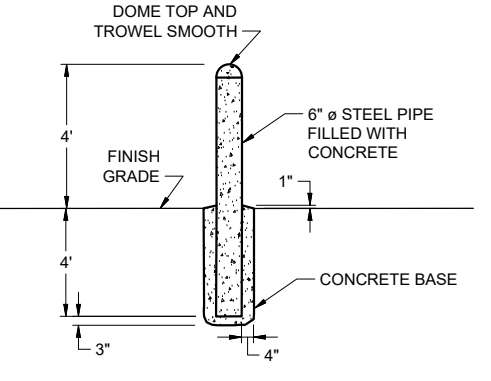

5 DETAIL: BOLLARD

C-501 SCALE: N.T.S

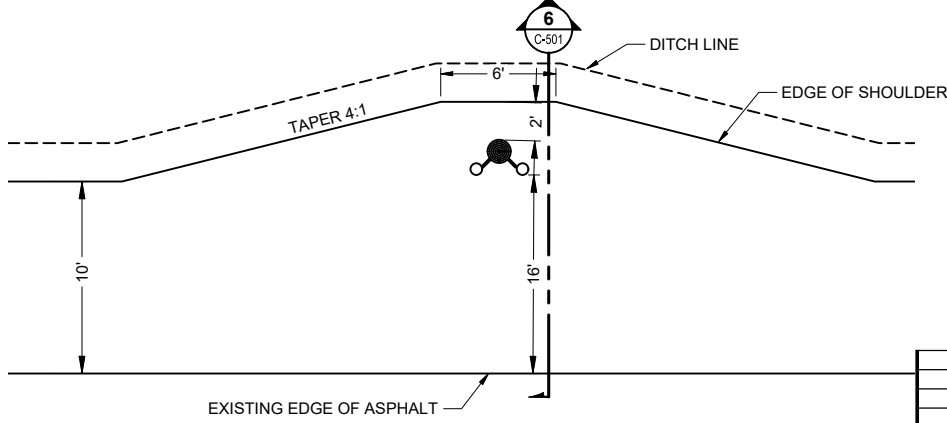

7 DETAIL: HYDRANT WIDENING PLAN

C-501 SCALE: N.T.S

REVISIONS	
No.	Date
1	08/27/2025
ADDENDUM No. 1	
ITEM	

CONSULTANT :

STATE OF ALASKA
49 TH
KAREN ANN BRADY
08/27/2025
CE 11523
REGISTERED PROFESSIONAL ENGINEER

Juneau, AK
9080 Mendocino Mall Rd. Ste. 4
Juneau, AK 99801
Phone: 907.586.3771
Fax: 907.586.3771
AEC 163270

PROJECT :

CITY & BOROUGH OF YAKUTAT
WATER SYSTEM EXTENSION

YAKUTAT, ALASKA

SHEET TITLE :

WATER PIPING DETAILS

DESIGN AMN
DRAWN HRB
CHECKED KAB
DATE 04-16-2025

PROJECT No.
10297.24002
SHEET NUMBER

C-501